


141 x 17

141 x 17

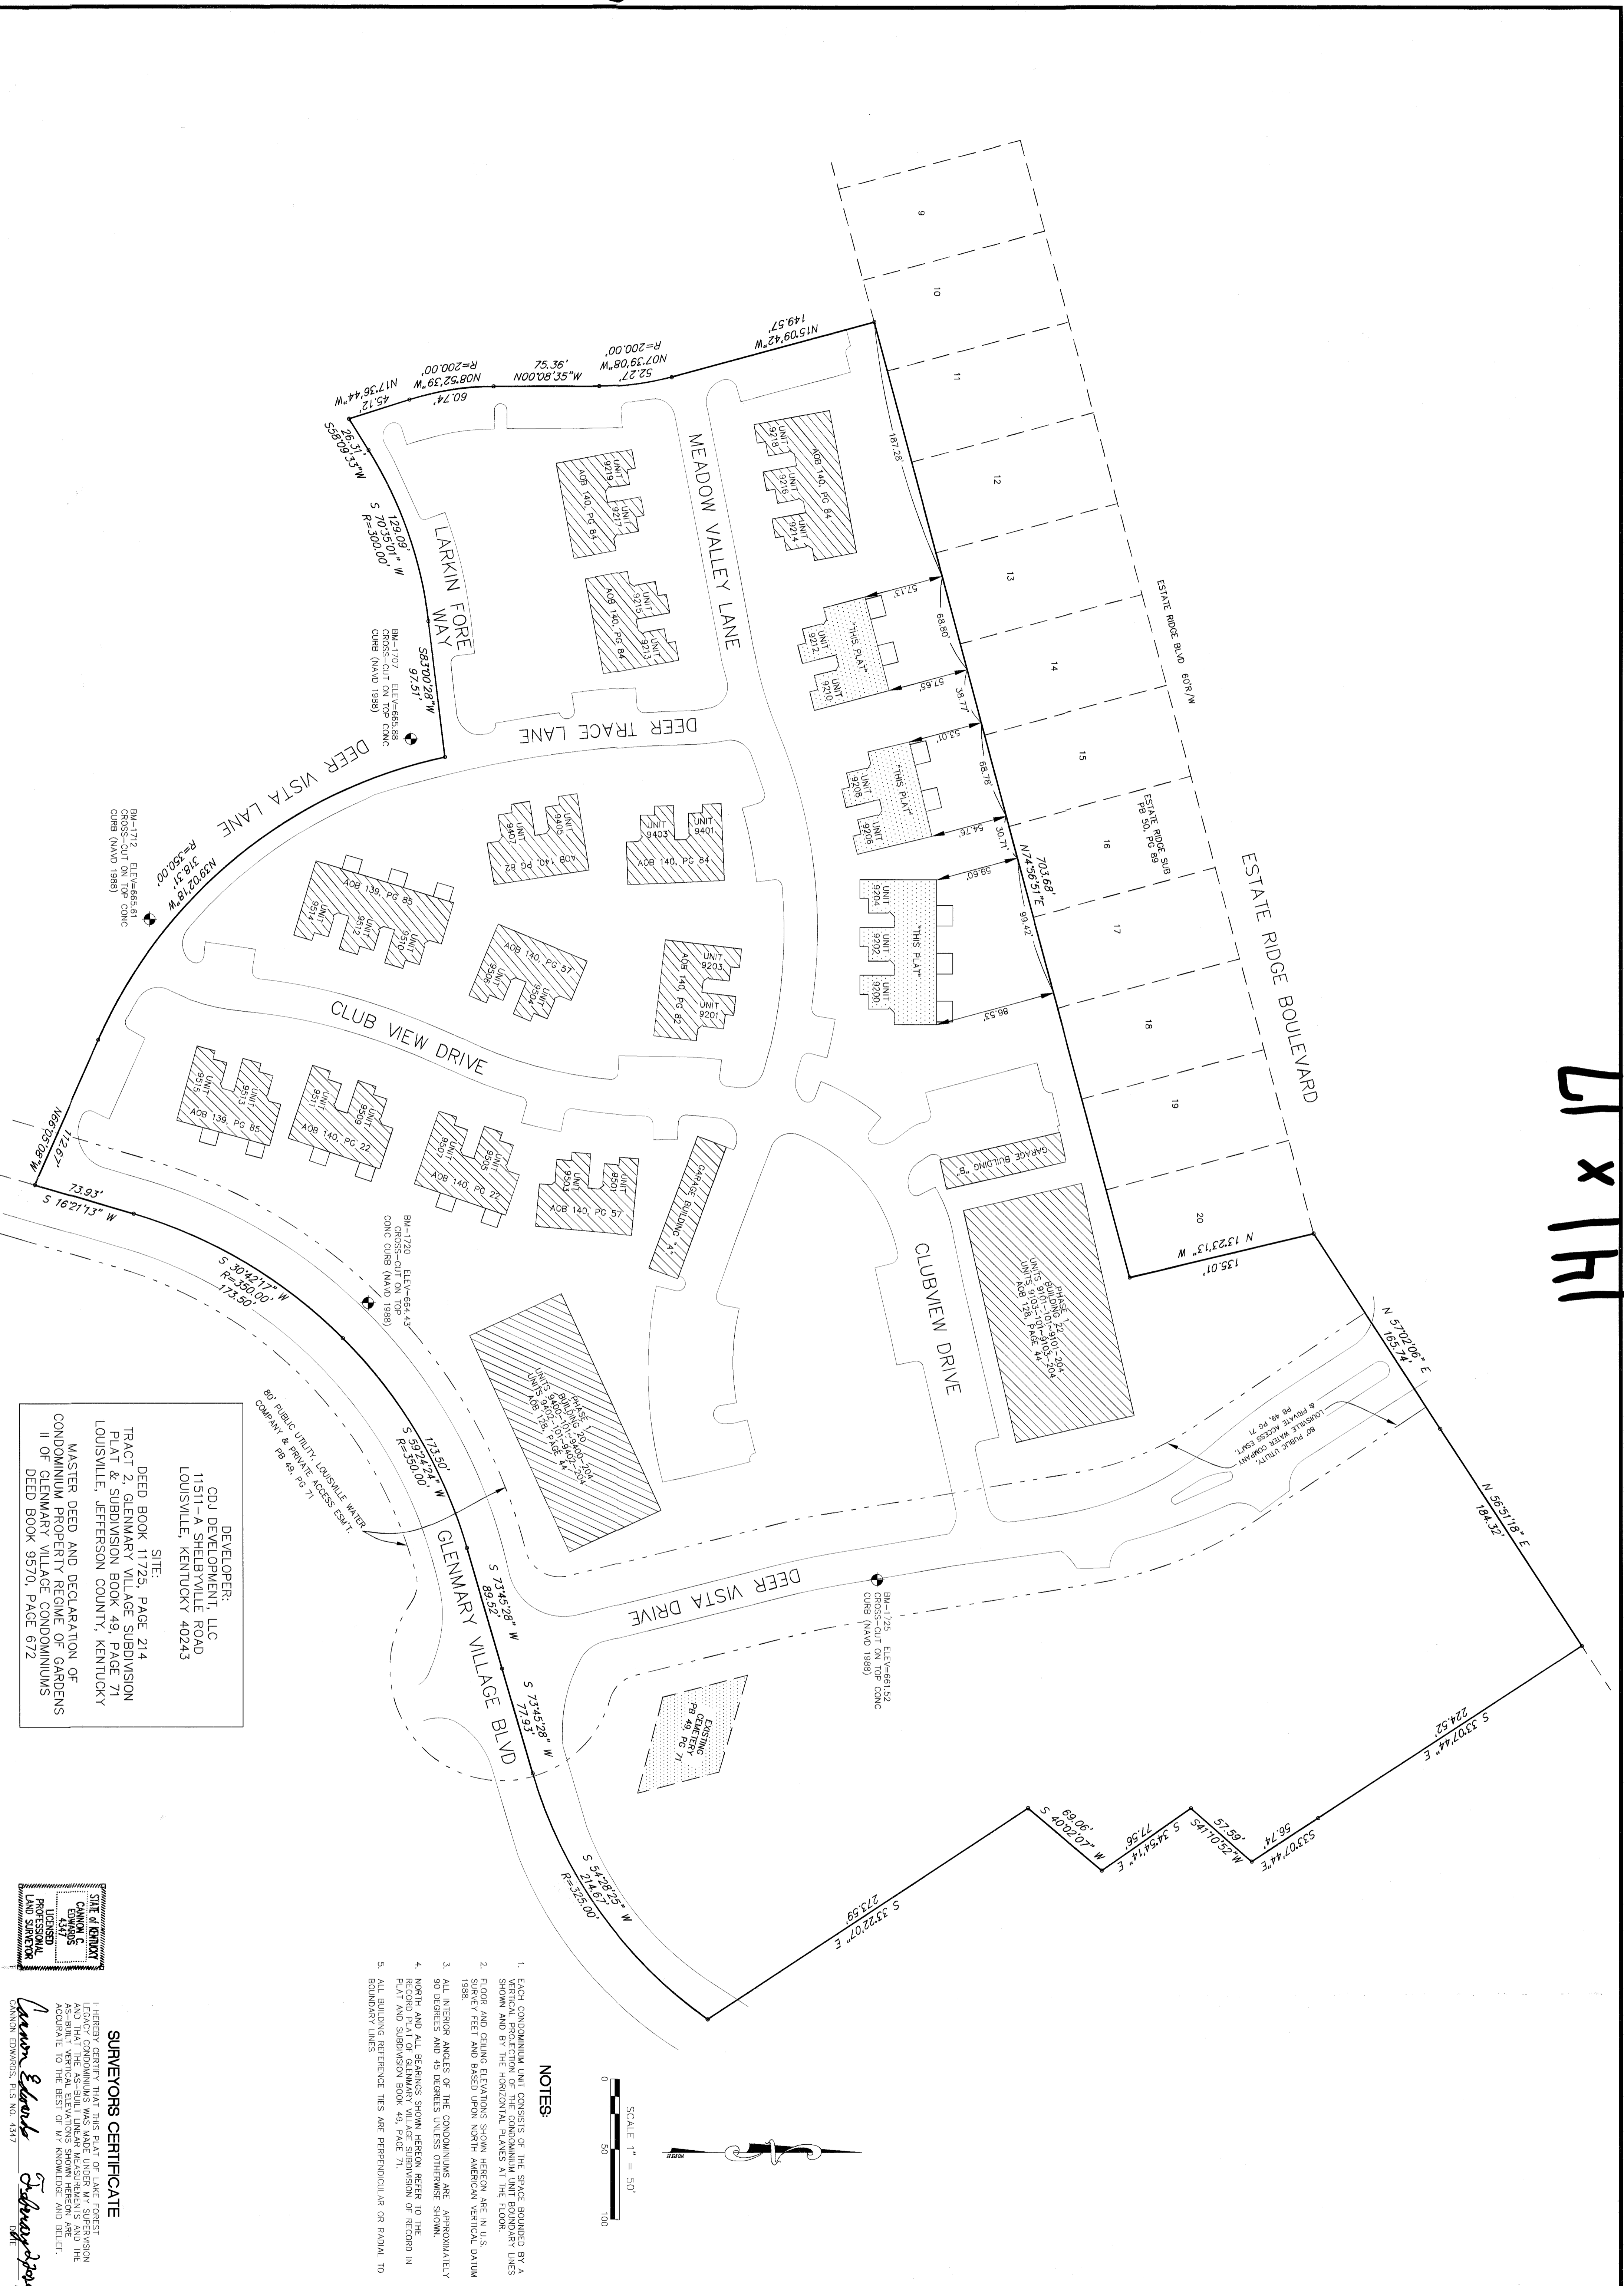

DEVELOPER:  
 CDJ DEVELOPMENT, LLC  
 11511-A SHELBYVILLE ROAD  
 LOUISVILLE, KENTUCKY 40243

SITE:  
 DEED BOOK 11723, PAGE 214  
 TRACT 2, GLENMARTY VILLAGE SUBDIVISION  
 PLAT & SUBDIVISION BOOK 49, PAGE 71  
 LOUISVILLE, JEFFERSON COUNTY, KENTUCKY

MASTER DEED AND DECLARATION OF  
 CONDOMINIUM PROPERTY REGIME OF GARDENS  
 II OF GLENMARTY VILLAGE CONDOMINIUMS  
 DEED BOOK 9570, PAGE 672


STATE OF KENTUCKY  
 CANNON C. EDWARDS  
 1547  
 PROFESSIONAL LAND SURVEYOR

**SURVEYORS CERTIFICATE**

I HEREBY CERTIFY THAT THIS PLAT OF LANE FOREST LEGACY CONDOMINIUMS WAS MADE UNDER MY SUPERVISION AS-BUILT VERTICAL ELEVATIONS SHOWN HEREON ARE ACCURATE TO THE BEST OF MY KNOWLEDGE AND BELIEF.

*Cannon Edwards*  
 CANNON EDWARDS, RES. NO. 4347

- NOTES:**
1. EACH CONDOMINIUM UNIT CONSISTS OF THE SPACE BOUNDED BY A VERTICAL PROJECTION OF THE CONDOMINIUM UNIT BOUNDARY LINES SHOWN AND BY THE HORIZONTAL PLANES AT THE FLOOR, FLOOR AND CEILING ELEVATIONS SHOWN HEREON ARE IN U.S. SURVEY FEET AND BASED UPON NORTH AMERICAN VERTICAL DATUM 1988.
  2. ALL INTERIOR ANGLES OF THE CONDOMINIUMS ARE APPROXIMATELY 90 DEGREES AND 45 DEGREES UNLESS OTHERWISE SHOWN.
  3. NORTH AND ALL BEARINGS SHOWN HEREON REFER TO THE RECORD PLAT AND SUBDIVISION BOOK 49, PAGE 71.
  4. ALL BUILDING REFERENCE TIES ARE PERPENDICULAR OR RADIAL TO BOUNDARY LINES.

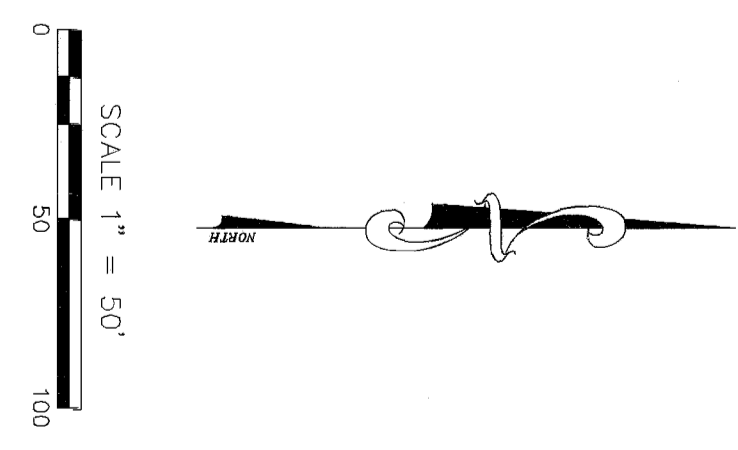

**GARDENS II OF GLENMARTY VILLAGE**

- UNIT NO. 9200 MEADOW VALLEY LANE
  - UNIT NO. 9202 MEADOW VALLEY LANE
  - UNIT NO. 9204 MEADOW VALLEY LANE
  - UNIT NO. 9206 MEADOW VALLEY LANE
  - UNIT NO. 9208 MEADOW VALLEY LANE
  - UNIT NO. 9210 MEADOW VALLEY LANE
  - UNIT NO. 9212 MEADOW VALLEY LANE
- LOUISVILLE, JEFFERSON COUNTY, KENTUCKY

**DEVELOPER:**  
 CDJ DEVELOPMENT, LLC  
 11511-A SHELBYVILLE ROAD  
 LOUISVILLE, KENTUCKY 40243

**SA BAK, WILSON & LINGO, INC**  
 ENGINEERS, LANDSCAPE ARCHITECTS & PLANNERS  
 THE HENRY CLAY 608 S. THIRD STREET, LOUISVILLE, KENTUCKY 40202 (502) 584 - 6271

JOB NO. 3106 COND0  
 SCALE: 1"=50'  
 DATE: FEBRUARY 1, 2024  
 DRAWING NO. 1 OF 2

141 x 17